


SCHEDULE OF ACCOMMODATION		
FRONT	HOUSE 1 _ 3 BED_6P	124m ²
	HOUSE 2 _ 3 BED_6P	124m ²
REAR	HOUSE 3 _ 3 BED_4P	104m ²
	HOUSE 4 _ 3 BED_4P	104m ²
	HOUSE 5 _ 3 BED_4P	104m ²
	HOUSE 6 _ 3 BED_4P	104m ²
TOTAL HOUSES		06

2 Proposed Site Section
1:200

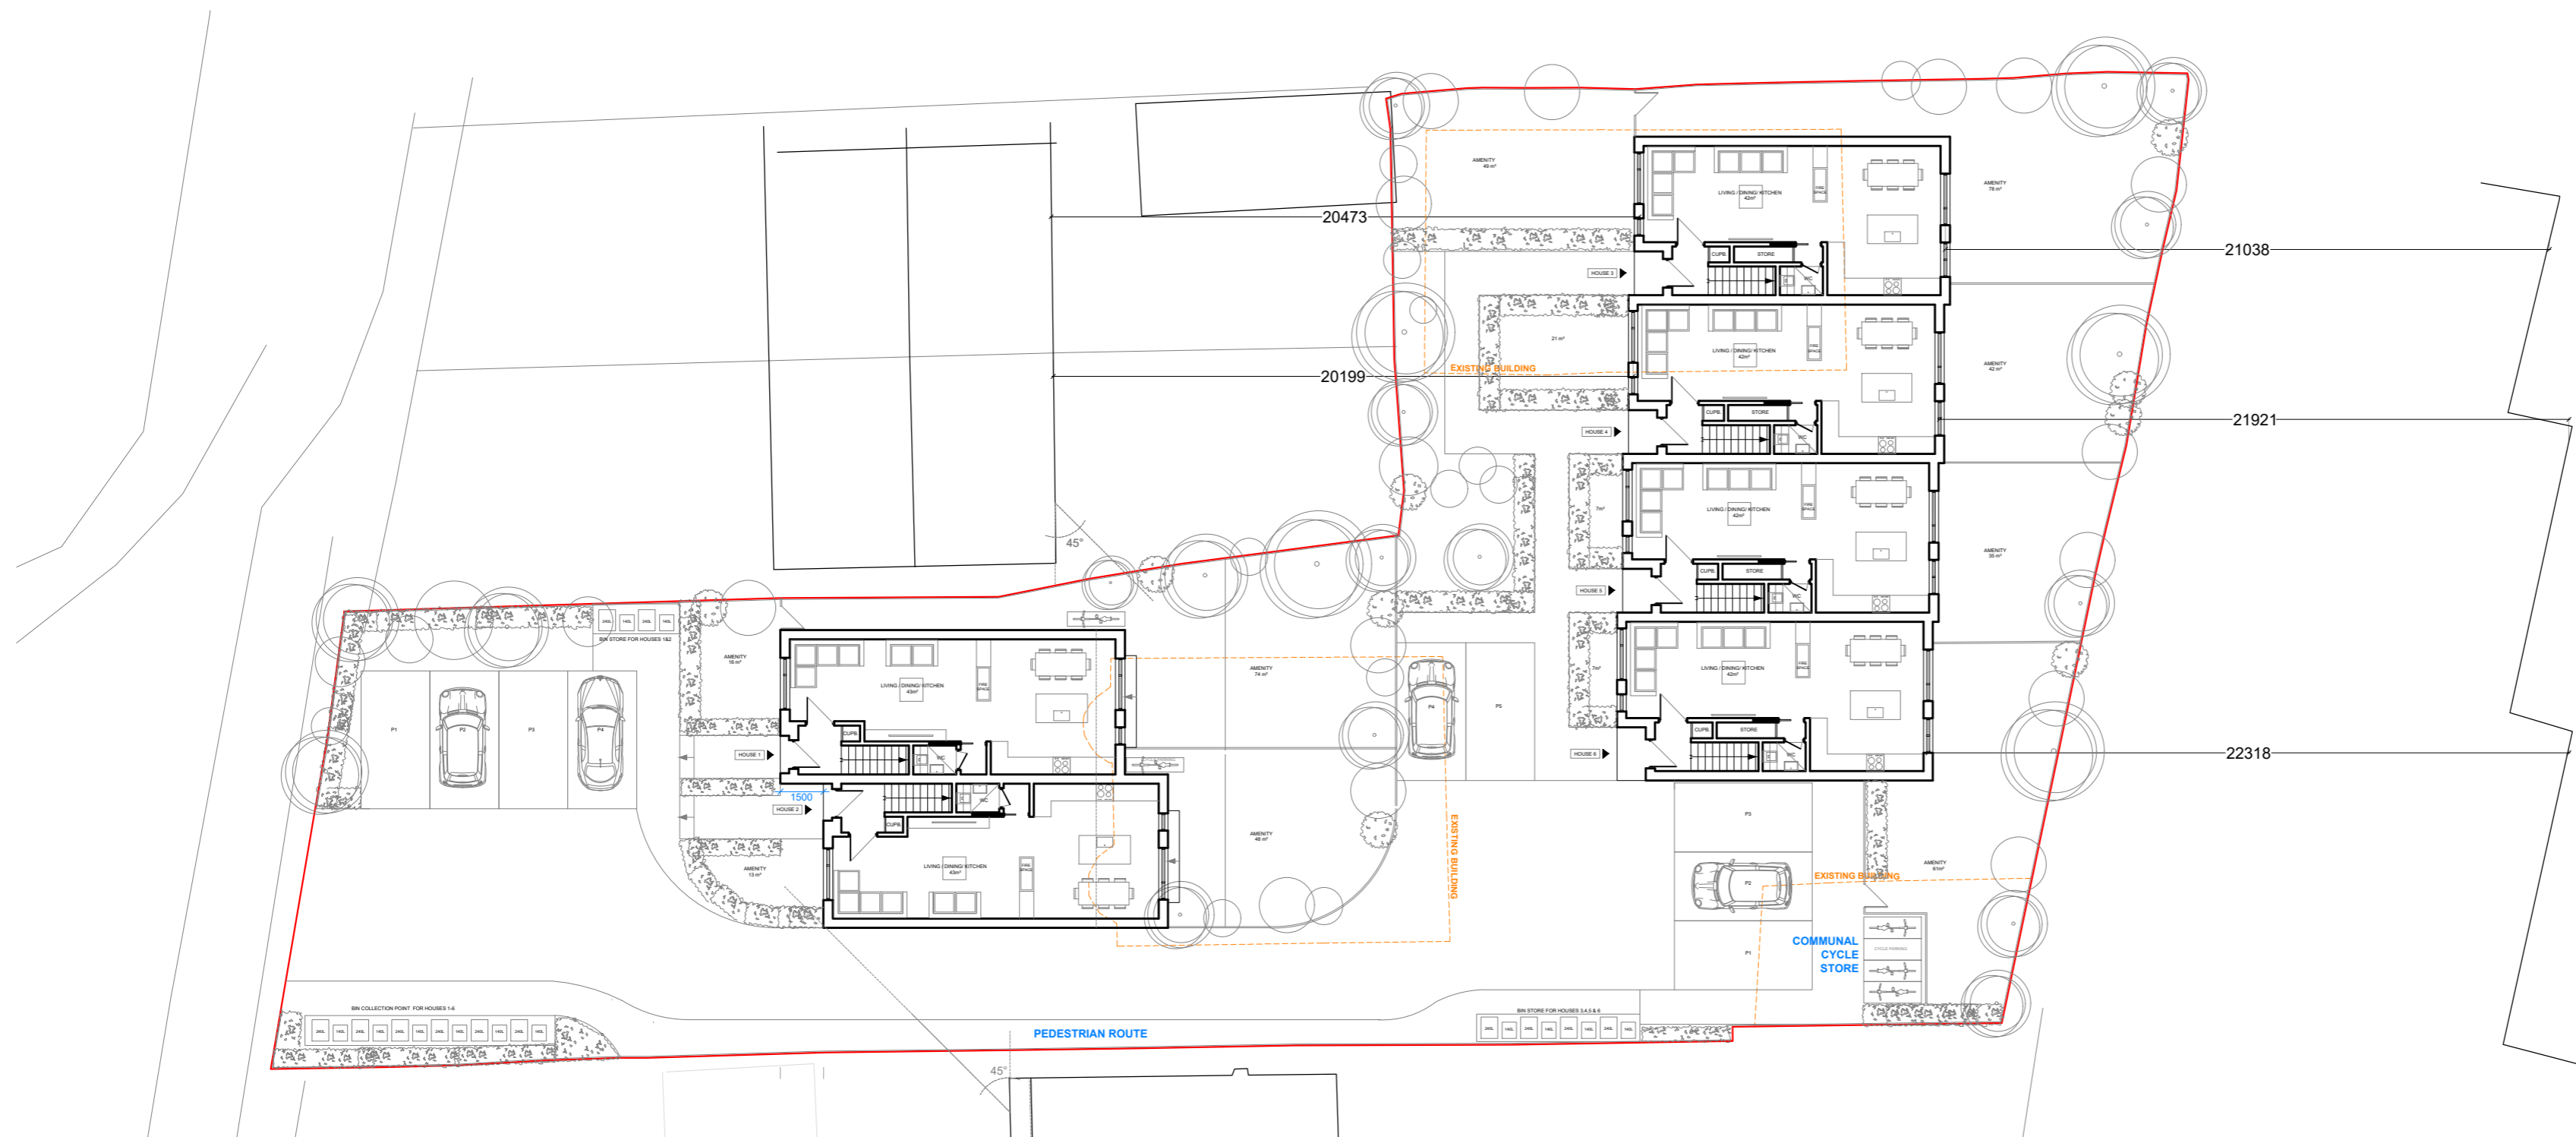

1 Proposed Site Plan
1:200

dpa
ARCHITECTS
INTERIOR DESIGNERS
PARTY WALL SURVEYORS
PLANNING CONSULTANTS

Hertfordshire Office
25 Tudor Hall
Brewery Road
Hoddesdon, Herts
EN11 8FP

London Office
9 Devonshire square
London
EC2M 4YF

RIBA

01992 469001
info@dpa-architects.co.uk
www.dpa-architects.co.uk

Rev	Date	Revision details	By
B	09 Nov 2022	- Communal Cycle Store Added - Marked up the Pedestrian Access - Position of the House 2 Updated - Flat Roof Area Reduced in Front Building	IK
A	05 Sep 2022	- Parking & Bin Updated - Separation Distance from Boundary, of Front Building Updated - Site Section Added	IK

Site address 314 Lodge Lane
Collier Row
Romford
RM5 2HX

Project Description Erection of
6 Residential
Dwellings

Drawing Title Proposed Site Plan & Section

Drawn IK

Checked by DP

Issued for Outline Planning

Scale 1:200@A2

Drawing No. 1514_310_B

Date June 2022